
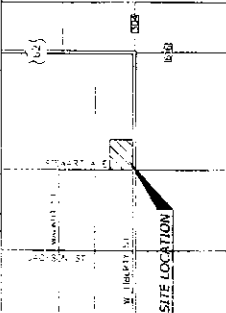


# AS-BUILT SURVEY

BEING LOTS #1208 - 1211 OF CITY OF HUBBARD,  
SITUATED IN THE CITY OF HUBBARD, COUNTY OF TRUMBULL, STATE OF OHIO  
0.8064 ACRES, (35,127 SqFt.)

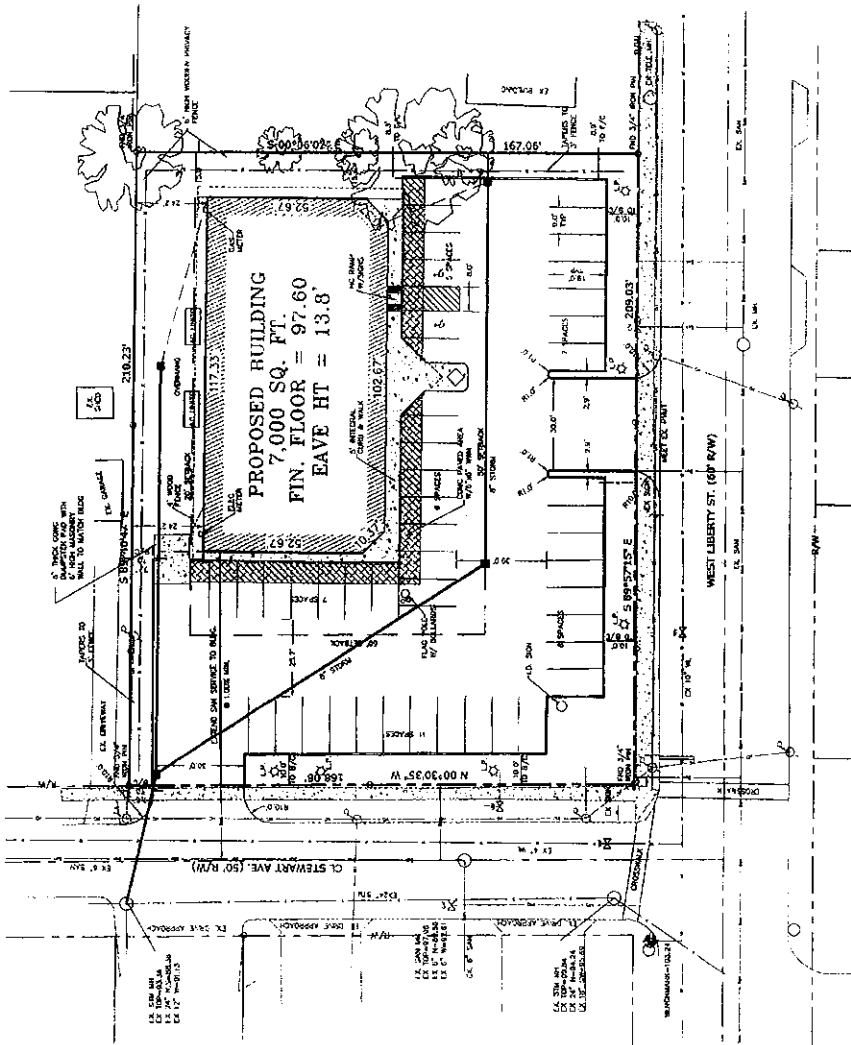

VICINITY MAP  
N.T.S.

SENIOR'S CERTIFICATION  
I, DANIEL R. STONE, REGISTERED PROFESSIONAL SURVEYOR, STATE OF OHIO, No. 8159, do hereby certify that the above described survey was made by me or under my direct supervision and that I am a duly licensed and registered professional surveyor in the State of Ohio. I am not aware of any fraud or other irregularities in this survey. My commission expires on 12/31/2006.  
27. Jan. 2006  
DANIEL R. STONE, REGISTERED PROFESSIONAL SURVEYOR



DEVELOPER/OWNER  
FAMILY VIDEO MOVIE CLUB  
1022 E. ADAMS  
SPRINGFIELD, IL 62703  
(217) 544-2001



VAN HORN, HOOVER & ASSOCIATES, INC.  
SURVEYING & ENGINEERING  
P.O. BOX 612  
TINDLAY, OHIO 45038  
(419) 423-6630  
E-MAIL: info@vanhornhoover.com



PROJECT	FAMILY VIDEO MOVIE CLUB
DATE	JAN 27 2006
DRAWN BY	JAK
CHECKED BY	DKS
SCALE	1" = 40'
DATE	01/26/06
PROJECT NO.	S. PROJECTS/6123
DATE	01/26/06
SCALE	1" = 40'

1 OF 1