Kent, OH
#321

AS-BUILT SURVEY
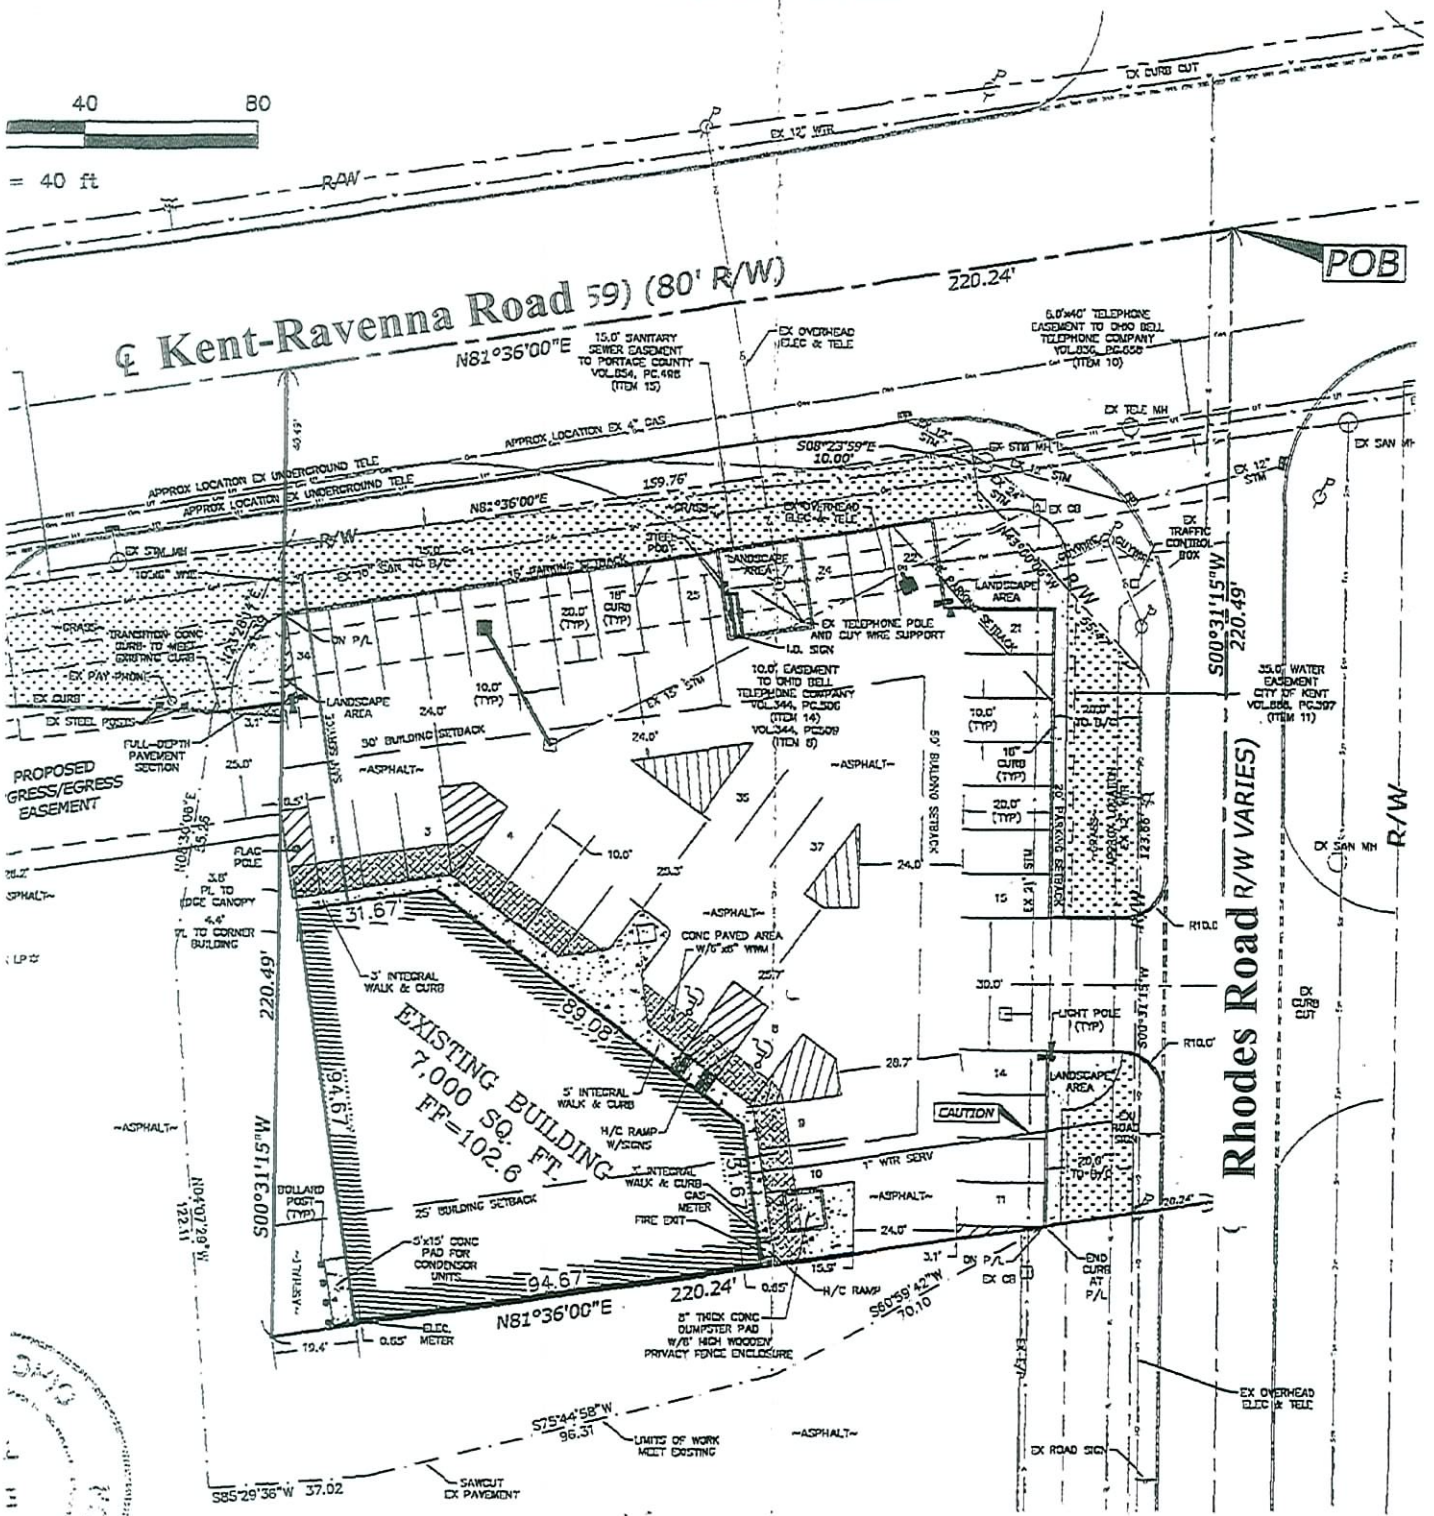
BEING A PART OF LOT 21 IN FRANKLIN TOWNSHIP,
COUNTY OF PORTAGE, STATE OF OHIO
1.1013 ACRES