FAMILY VIDEO STORE - AS-BUILT SITE PLAN
COLLINSVILLE, ILLINOIS

SHEET 1 of 1

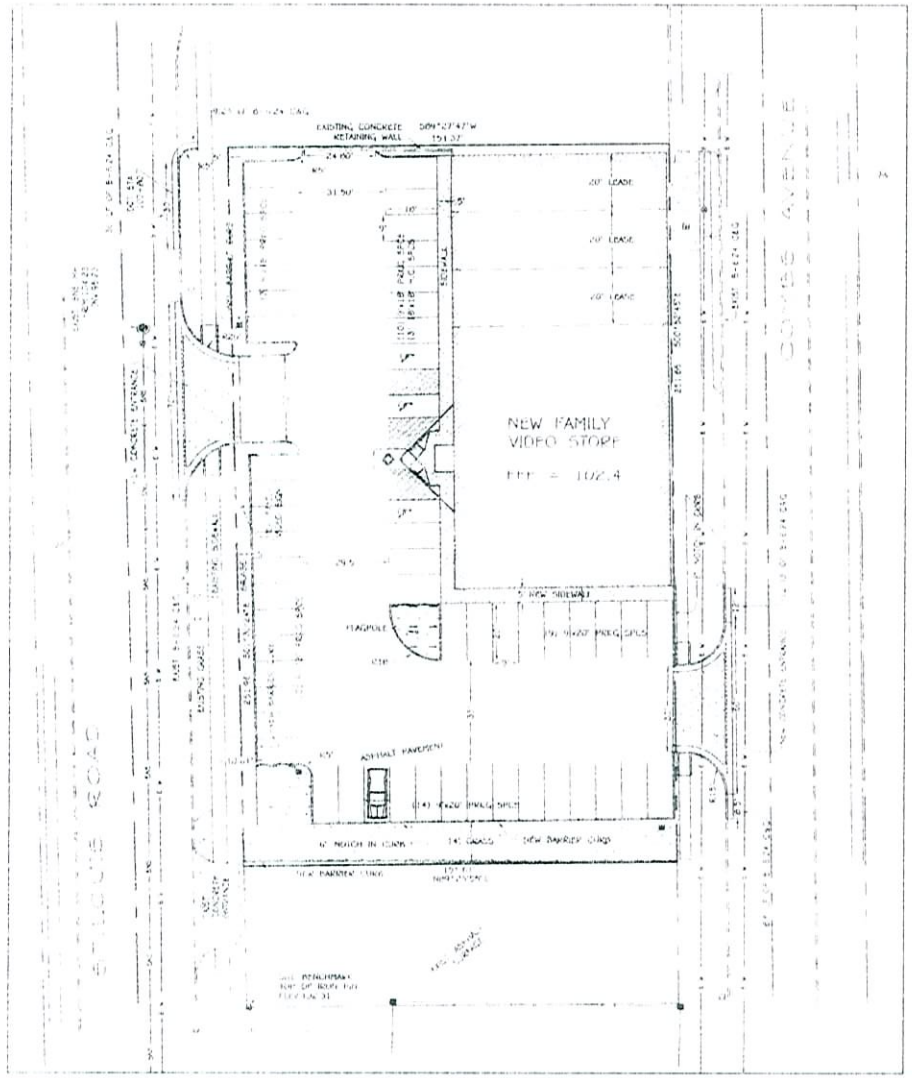

GRAPHIC SCALE

REDUCED SIZED PLANS WILL NOT CONFORM TO STANDARD ENGINEERING SCALES. MULTIPLY ABOVE SCALE TIMES TWO (2)

LEGEND

- BOUNDARY LINE
- CENTER LINE
- FENCE LINE
- RIGHT-OF-WAY
- SANITARY SEWER LINE
- WATER LINE
- STORM SEWER LINE
- IRON PIN FOUND
- FENCE CORNER POST
- UTILITY POLE
- SAN MANHOLE
- STORM INLET / MANHOLE
- LIGHT POLE
- WATER METER
- FIRE HYDRANT
- WATER VALVE

REGISTERED PROFESSIONAL ENGINEER

EXPIRES 11-30-07

PARKING SUMMARY
(13) 9'x20' STALLS
(36) 9'x18' STALLS
(3) 18'x18' HANDICAP STALL
52 = TOTAL # OF PARKING STALLS

ZONING
ZONED: B-2, LIMITED COMMERCIAL DISTRICT

LOCAL UTILITIES
ELECTRIC
ILLINOIS POWER COMPANY
PH: 800 755-5000
SOUTHWESTERN ELECT. COOP
PH: (618)664-1025
NATURAL GAS
ILLINOIS POWER COMPANY
PH: 800 755-5000
TELEPHONE
ILLINOIS BELL TELEPHONE CO.
PH: 800 635-1500
WATER & SEWER SERVICE
CITY OF COLLINSVILLE

ROCKFORD CONSTRUCTION INC

family Video

Round Table Design INC
ARCHITECTURE - PROFESSIONAL ENGINEERING - LAND SURVEYING

NEW FAMILY VIDEO STORE
COLLINSVILLE, ILLINOIS

AS-BUILT SITE PLAN

AB1